

Replacement Sheet Title: Alternate Coke Furnace Tube Arrangement Inventor: Brian Jay Doerksen S.N.: 09/872,390

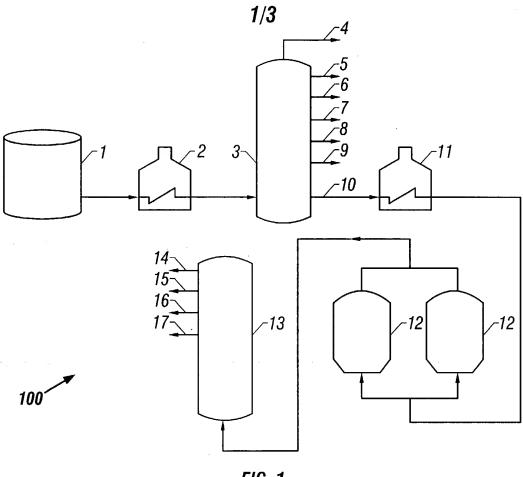


FIG. 1

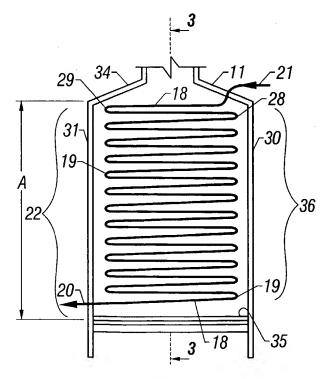



FIG. 2




Replacement Sheet

Title: Alternate Coke Furnace Tube Arrangement Inventor: Brian Jay Doerksen S.N.: 09/872,390

*2/3* 

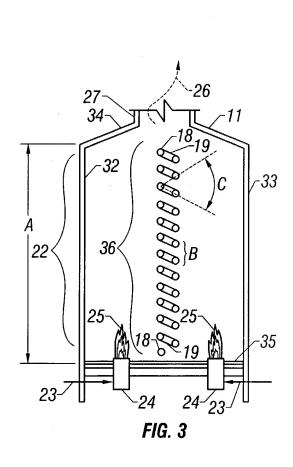

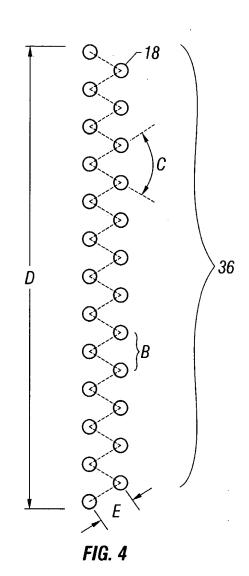



Replacement Sheet Title: Alternate Coke Furnace Tube Arrangement Inventor: Brian Jay Doerksen

S.N.: 09/872,390

3/3

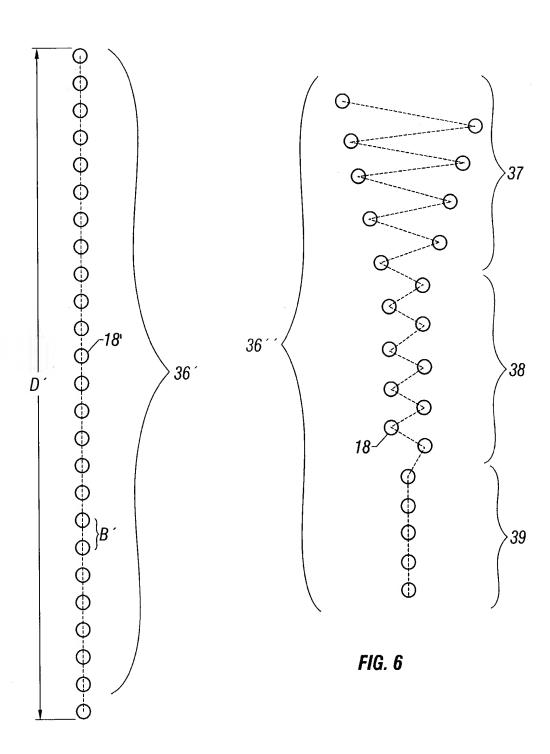



FIG. 5




Annotated Marked-Up Drawings
Title: Alternate Coke Furnace Tube Arrangement

Inventor: Brian Jay Doerksen

S.N.: 09/872,390

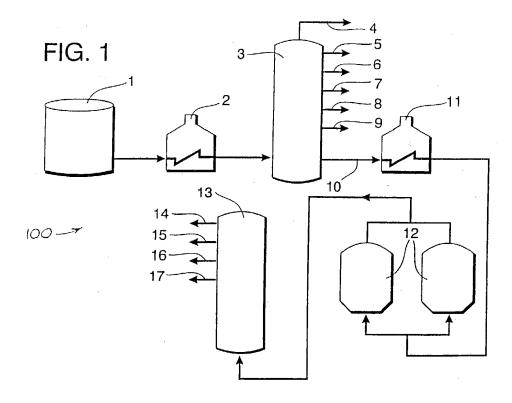

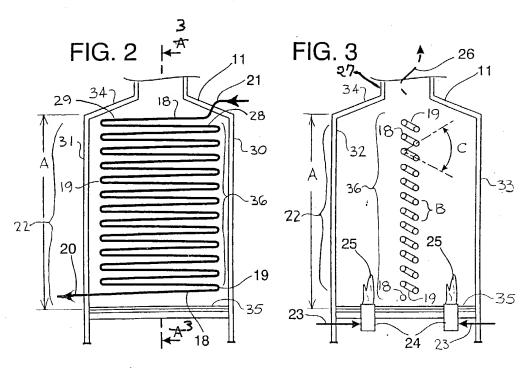



Annotated Marked-Up Drawings
Title: Alternate Coke Furnace Tube Arrangement
Inventor: Brian Jay Doerksen

S.N.: 09/872,390

FIG. 5


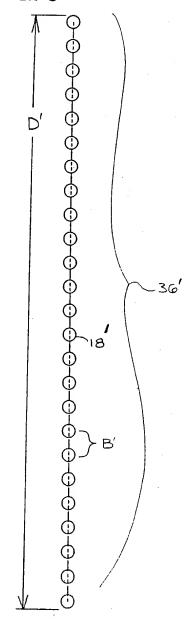


FIG. 4



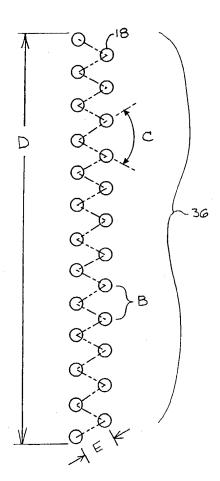

Annotated Marked-Up Drawings Title: Alternate Coke Furnace Tube Arrangement Inventor: Brian Jay Doerksen S.N.: 09/872,390

FIG.6

